


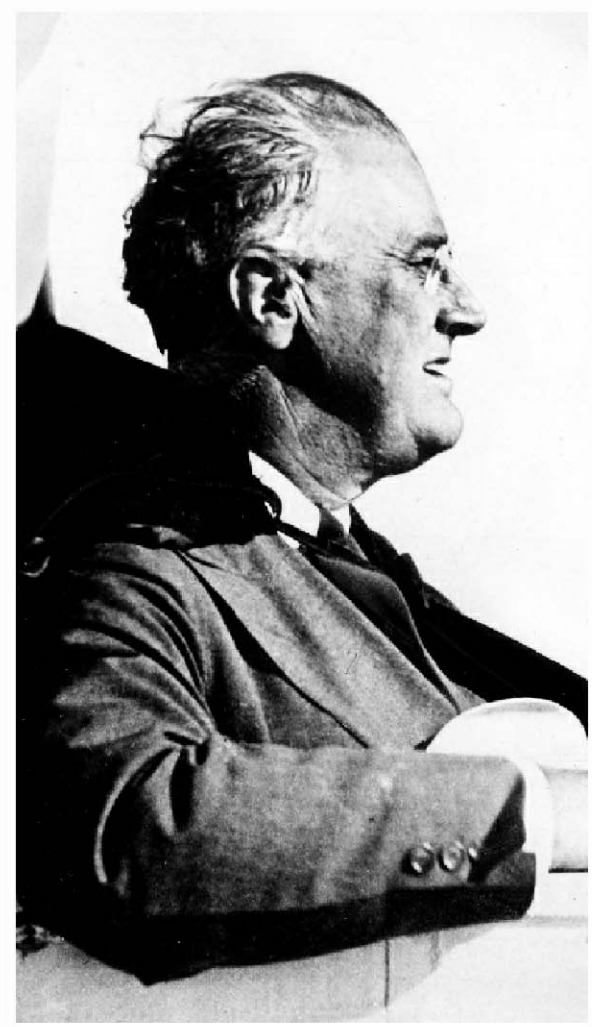

FRANKLIN D. ROOSEVELT FOUR FREEDOMS PARK

CONCEPT AND DESIGN BY
LOUIS I. KAHN, FAIA (1901-1974)

Architect of Record:
MITCHELL/GIURGOLA ARCHITECTS, LLP
630 NINTH AVENUE, SUITE 711
NEW YORK, NY 10025

Geotechnical & Civil Engineer:
LANGAN ENGINEERING &
ENVIRONMENTAL SERVICES
RIVER DRIVE CENTER, 1
ELMWOOD PARK, NJ 07407

Structural Engineer:
WEIDLINGER ASSOCIATES INC.
375 HUDSON STREET
NEW YORK, NY 10014

MEP Engineer:
JOSEPH R. LORING
AND ASSOCIATES, INC.
21 PENN PLAZA, 14TH FLOOR
360 WEST 31ST STREET
NEW YORK, NY 10001


Landscape Architect:
LUIS VILLA/ LOIS SHERR ASSOCIATED
870 UN PLAZA
NEW YORK, NY 10017

Copyright © 2008, Mitchell/Giurgola Architects
All dimensions and existing conditions shall
be checked & verified by the contractor before
proceeding with the work.

ISSUE FOR CONSTRUCTION

No.	Date	Comments
1	02/01/2010	BULLETIN 3
2	06/15/2010	BULLETIN 7
3	06/15/2010	BULLETIN 10
4	01/15/2012	BULLETIN 13
5	05/08/2012	BULLETIN 14
6	09/12/2013	CONSTRUCTION RECORD DRAWINGS

KEY PLAN

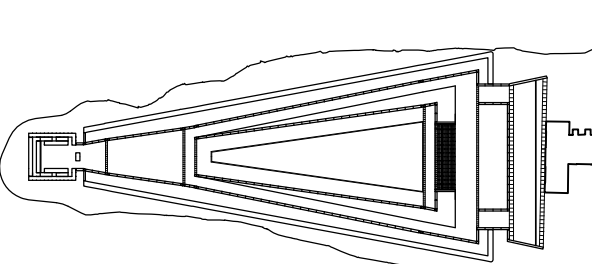


Project:
FRANKLIN D. ROOSEVELT FOUR FREEDOMS PARK

Drawing Title:

SITE PLAN


PROJECT NO: 071209 SCALE: 1" = 20'-0"
TRADE: DATE: 08-25-2009

A1.01

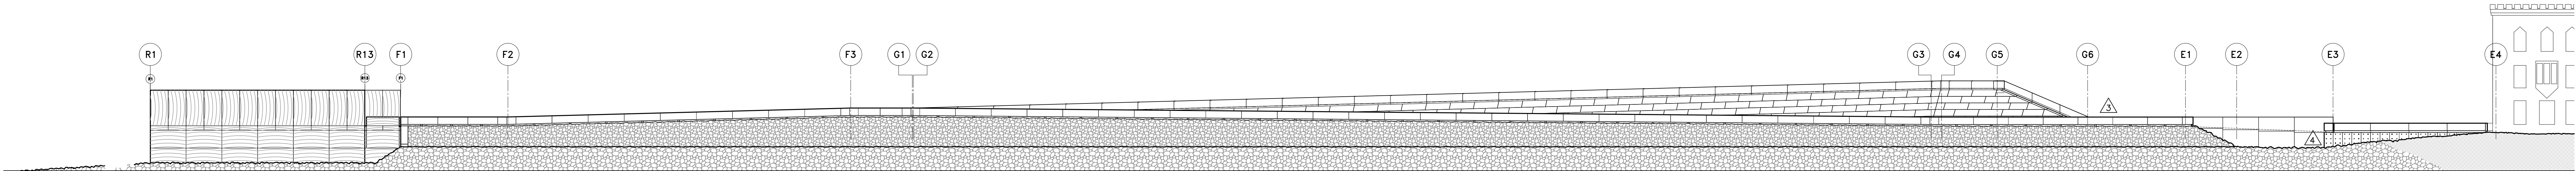

02 EAST ELEVATION

SCALE: 1" = 20'-0"

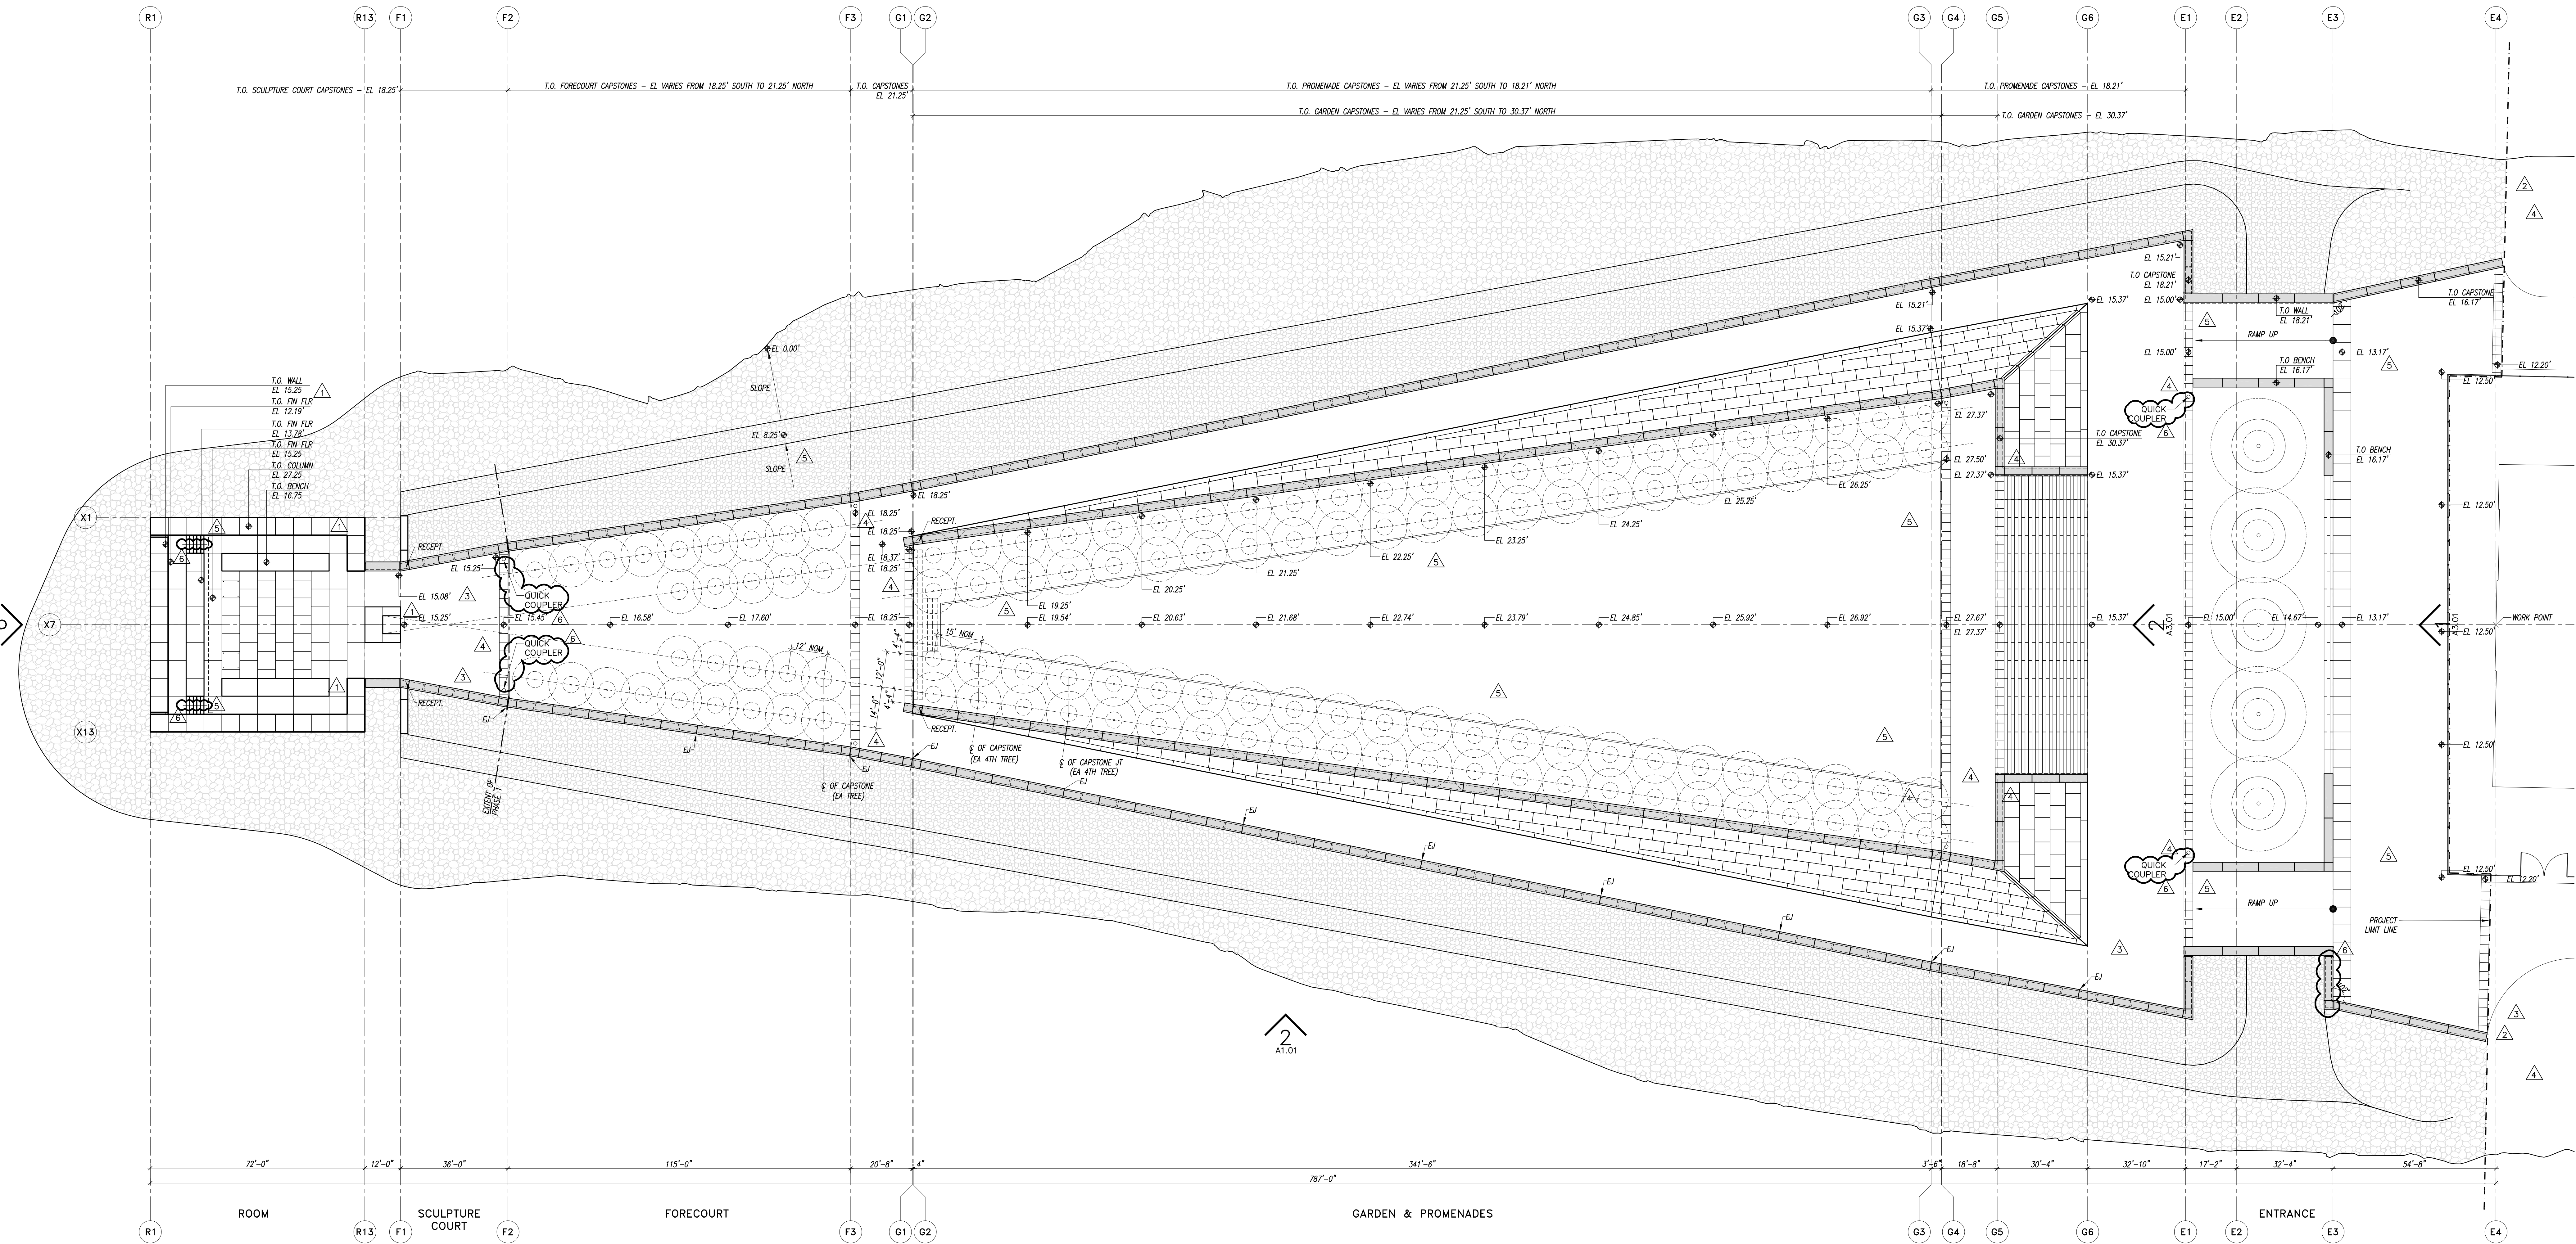

01 PLAN

SCALE: 1" = 20'-0"